RESERVED FOR CLERK OF THE SUPERIOR COURT

RECEIVED
V-22-0003
JAN 11 2022

City of Johns Creek
Community Development

GRAPHIC SCALE

30 0 15 30 60

(IN FEET)
1 inch = 30 ft.

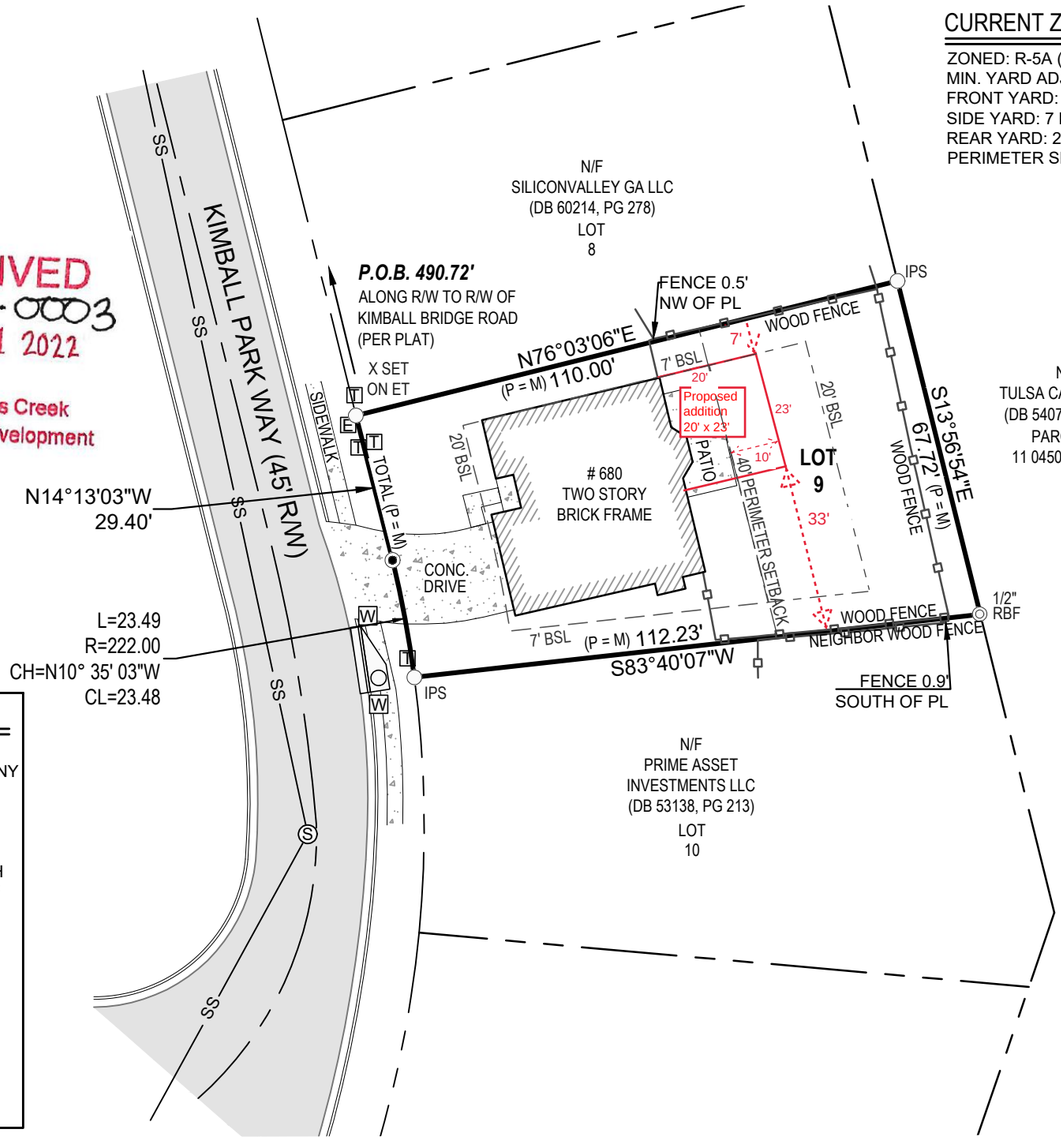

CURRENT ZONING

ZONED: R-5A (FULTON COUNTY)
MIN. YARD ADJACENT TO PUBLIC STREET
FRONT YARD: 20 FEET (PER PLAT)
SIDE YARD: 7 FEET
REAR YARD: 20 FEET
PERIMETER SETBACK: 40 FEET

AREA

6,646 sq.ft.
0.15 acres

LEGEND

- POWER POLE
- FIRE HYDRANT
- WATER VALVE
- WM WATER METER
- JUNCTION BOX
- SANITARY SEWER MANHOLE
- DROP INLET
- R/W MONUMENT
- SINGLE WING CATCH BASIN
- DOUBLE WING CATCH BASIN
- CURB INLET
- HEADWALL
- GAS METER
- GAS VALVE
- ELECTRIC TRANSFORMER
- TELEPHONE PEDESTAL
- LIGHT POST
- 1/2 IRON PIN SET (IPS)
- REBAR FOUND (RBF)
- CONC. MONUMENT FOUND (CMF)
- CALCULATED POINT
- C.L.F. CHAIN LINK FENCE
- CTF CRIMP TOP PIPE FOUND
- OTF OPEN TOP PIPE FOUND
- IPF IRON PIN OR OR ROD FOUND

SURVEYORS CERTIFICATION

THIS PLAT IS A RETRACEMENT OF AN EXISTING PARCEL OR PARCELS OF LAND AND DOES NOT SUBDIVIDE OR CREATE A NEW PARCEL OR MAKE ANY CHANGES TO ANY REAL PROPERTY BOUNDARIES. THE RECORDING INFORMATION OF THE DOCUMENTS, MAPS, PLATS, OR OTHER INSTRUMENTS WHICH CREATED THE PARCEL OR PARCELS ARE STATED HEREON. RECORDATION OF THIS PLAT DOES NOT IMPLY APPROVAL OF ANY LOCAL JURISDICTION, AVAILABILITY OF PERMITS, COMPLIANCE WITH LOCAL REGULATIONS OR REQUIREMENTS, OR SUITABILITY FOR ANY USE OR PURPOSE OF THE LAND. FURTHERMORE, THE UNDERSIGNED LAND SURVEYOR CERTIFIES THAT THIS PLAT COMPLIES WITH THE MINIMUM TECHNICAL STANDARDS FOR PROPERTY SURVEYS IN GEORGIA AS SET FORTH IN THE RULES AND REGULATIONS OF THE GEORGIA BOARD OF REGISTRATION FOR PROFESSIONAL ENGINEERS AND LAND SURVEYORS AND AS SET FORTH IN O.C.G.A. SECTION 15-6-67.

1/6/2022

CULLEN PRESTON HARDEE *DATE*
REGISTERED LAND SURVEYOR #3144

SURVEY NOTES

1. EQUIPMENT USED : TOPCON ROBOTIC D2 TOTAL STATION - TOPCON RTK GPS ROVER.
2. THE FIELD DATA UPON WHICH THIS MAP OR PLAT IS BASED HAS A CLOSURE PRECISION OF ONE FOOT IN 15,000 FEET AN ANGULAR ERROR OF 02" PER ANGLE POINT AND WAS ADJUSTED USING COMPASS RULE.
3. THIS MAP OR PLAT HAS BEEN CALCULATED FOR CLOSURE AND IS FOUND TO BE ACCURATE WITHIN ONE FOOT IN 100,000 FEET.
4. THIS PROPERTY IS SUBJECT TO ALL ZONING ORDINANCES, SETBACK LINES AND EASEMENTS OF RECORD LYING WITHIN.
5. AS SHOWN ON FLOOD INSURANCE RATE MAPS OF FULTON COUNTY, GEORGIA COMMUNITY PANEL NUMBER 13121C0079F THIS PROPERTY IS NOT LOCATED WITHIN A 100 YEAR FLOOD ZONE.

THIS PLAT WAS PREPARED FOR THE EXCLUSIVE USE OF THE PERSON, PERSONS, OR ENTITY NAMED IN THE CERTIFICATE HEREON. SAID CERTIFICATE DOES NOT EXTEND TO ANY UNNAMED PERSON WITHOUT AN EXPRESS RE-CERTIFICATION BY THE SURVEYOR NAMING SAID PERSON.

UNITED LAND SURVEYING, LLC. ALL RIGHTS ARE RESERVED. ANY POSSESSION, REPRODUCTION OR OTHER USE OF THIS DOCUMENT WITHOUT PRIOR WRITTEN PERMISSION FROM UNITED LAND SURVEYING, LLC. IS EXPRESSLY PROHIBITED.

JOB NUMBER: 21-1165

GEORGIA REGISTERED NO. 3144 CULLEN PRESTON HARDEE LAND SURVEYOR

PLAT DATE:	1/6/2022
FIELD DATE:	12/22/2021
SCALE:	1"=30'
DRAWN BY:	J.A.M.
REVIEWED BY:	C.P.H.

REVISIONS

1.	
2.	
3.	
4.	

LEGAL REFERENCE:

DEED BOOK: 55232	PAGE: 366
PLAT BOOK: 203	PAGE: 87

SHEET 1 OF 1

AS-BUILT BOUNDARY SURVEY

GAURANG PATEL

LOT 9

KIMBALL PARC SUBDIVISION

LAND LOT 193, 1ST DISTRICT

1ST SECTION, FULTON COUNTY

GEORGIA

1258 CONCORD ROAD SE SUITE 103
SMYRNA, GEORGIA 30080
Ph. (678) 293-5232

VISIT US ON OUR WEBSITE:
www.united-uls.com

UNITED LAND SURVEYING
COA NO. LSF 001321